


THOMAS & BEER RESIDENCE
 2302 NORTH KENMORE STREET
 MAYWOOD ARLINGTON, VA 22207

EXISTING UPPER FLOOR PLAN
 SCALE: 1-8" = 1'-0"


JULY 2013
AS-BUILT

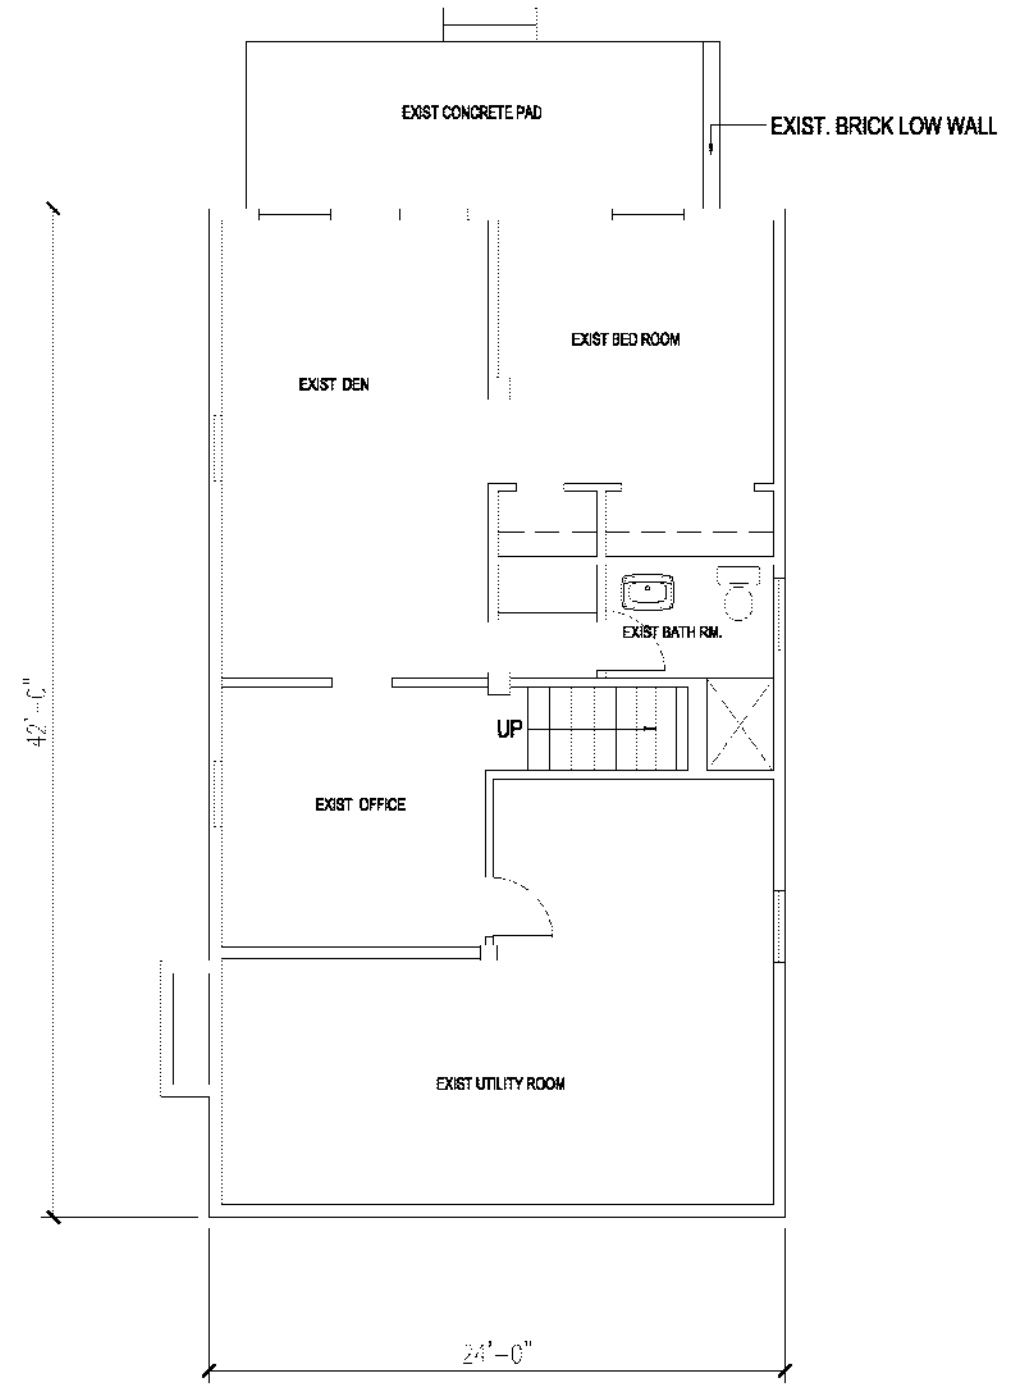


THOMAS & BEER RESIDENCE
2302 NORTH KENMORE STREET
MAYWOOD ARLINGTON, VA 22207


EXISTING LOWER FLOOR PLAN
SCALE: 1-8" = 1'-0"

JULY 2013
AS-BUILT

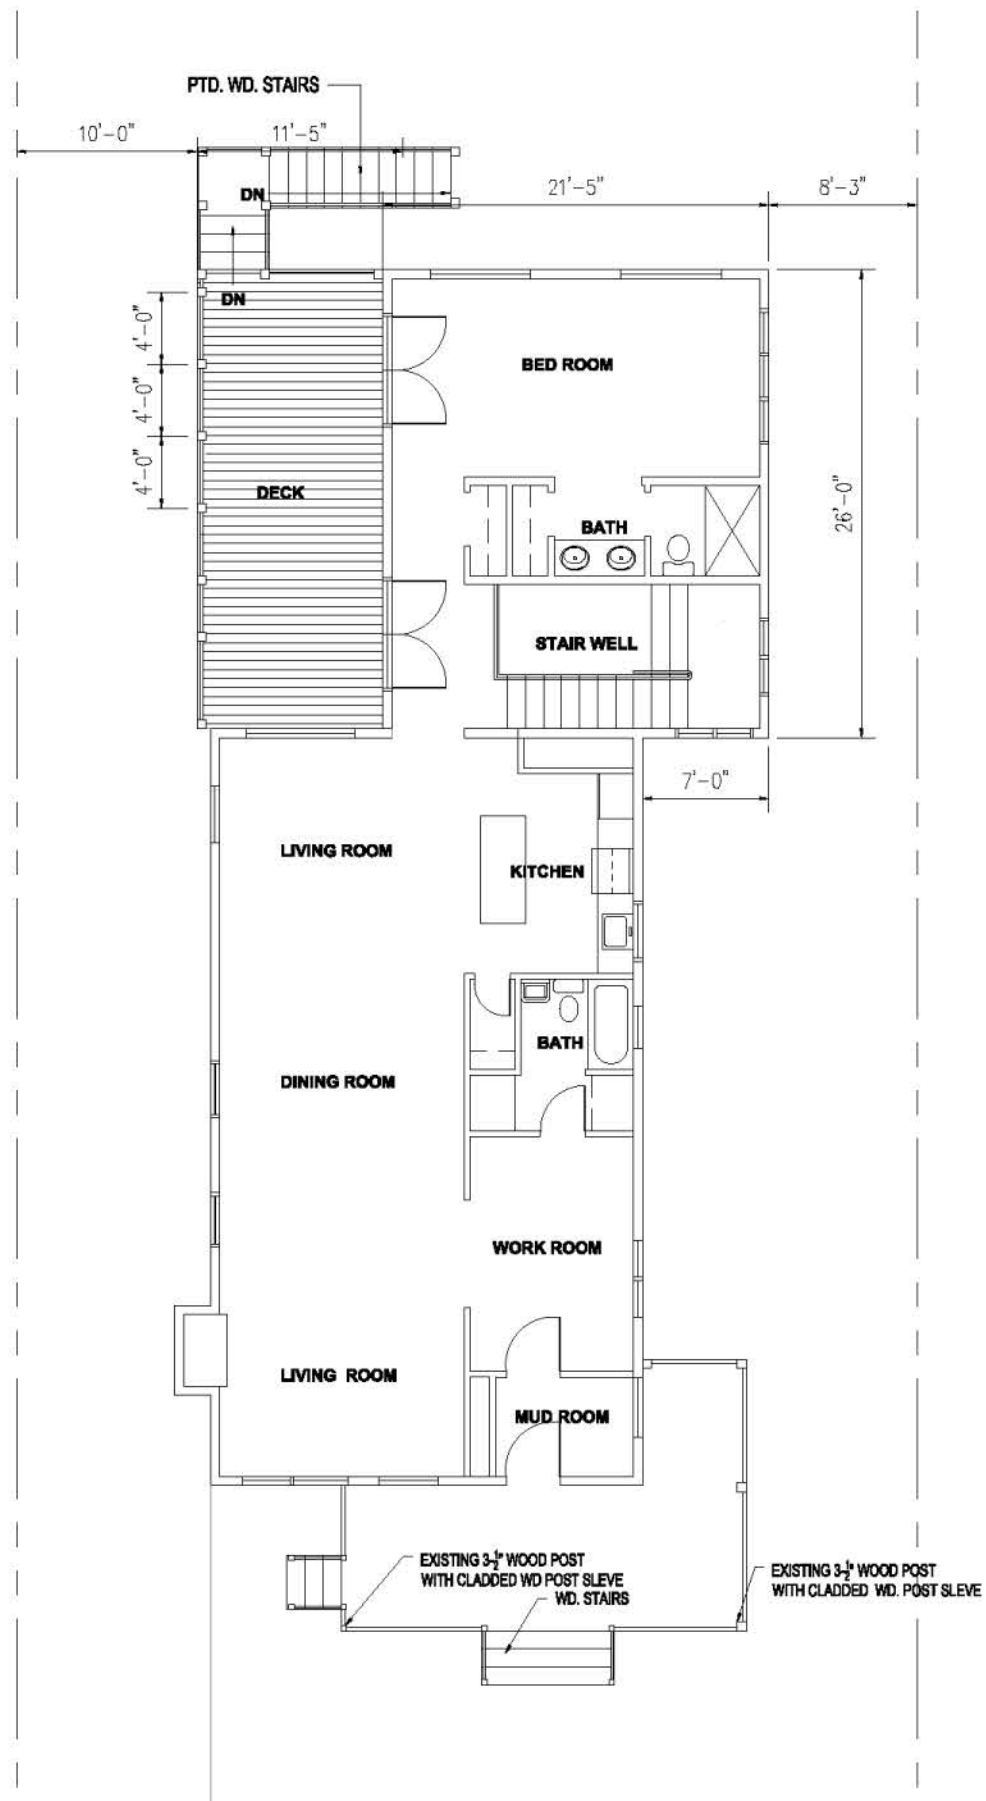

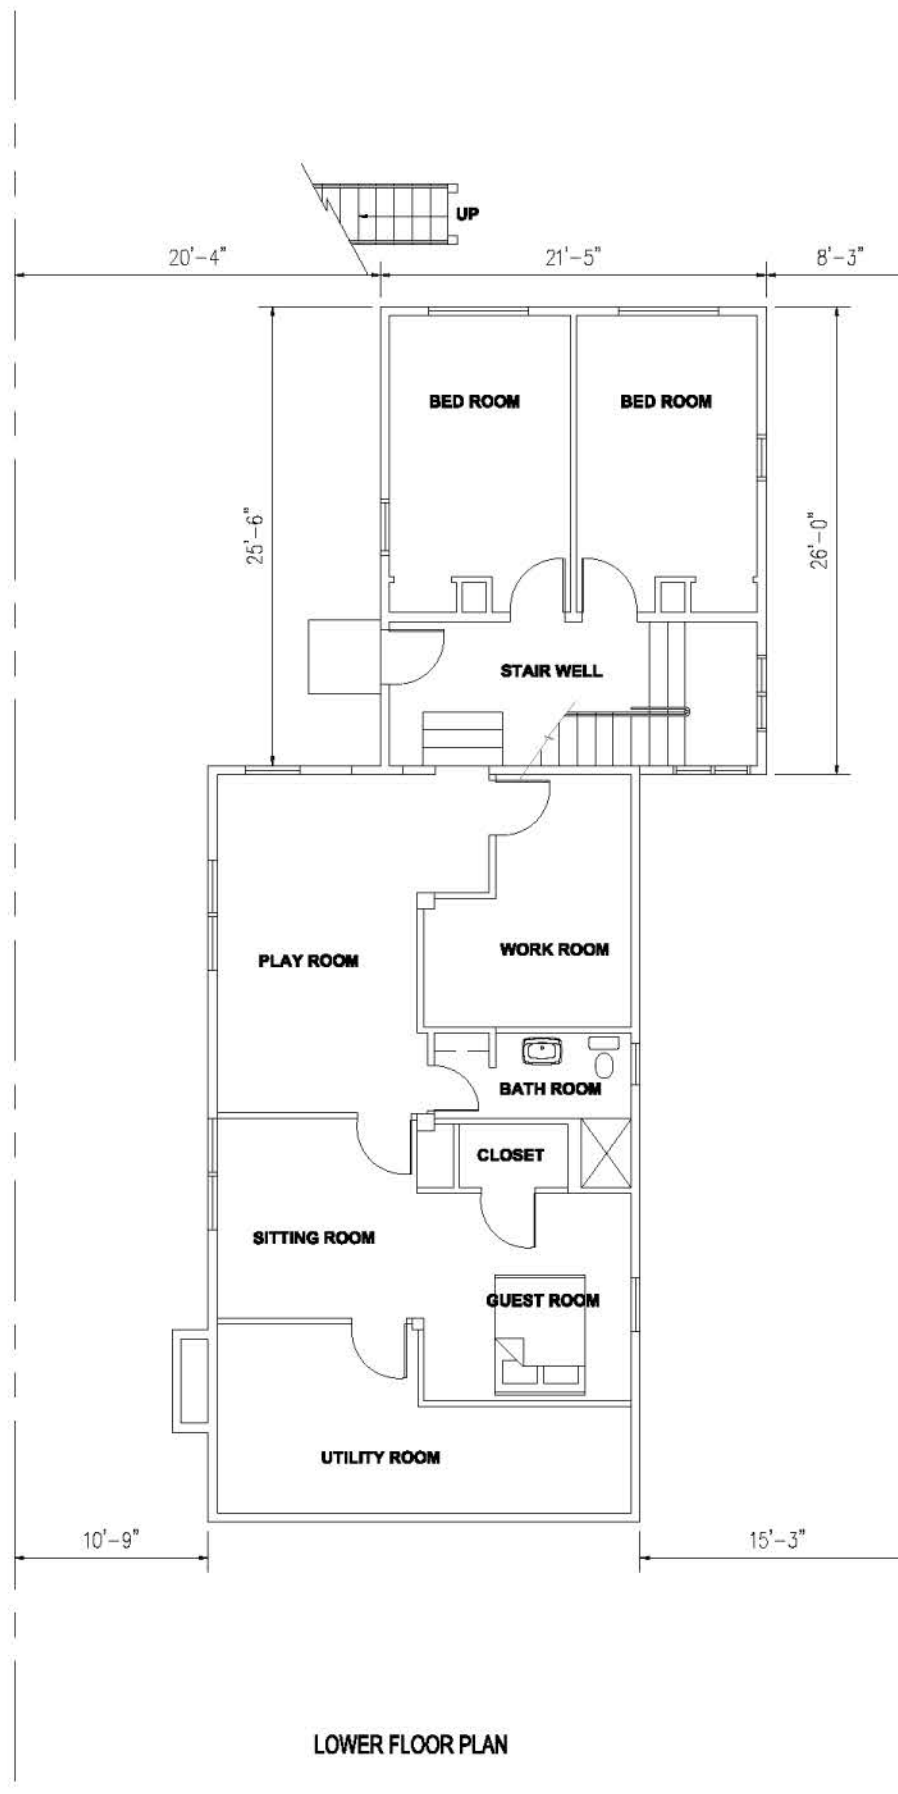

LOWER FLOOR PLAN

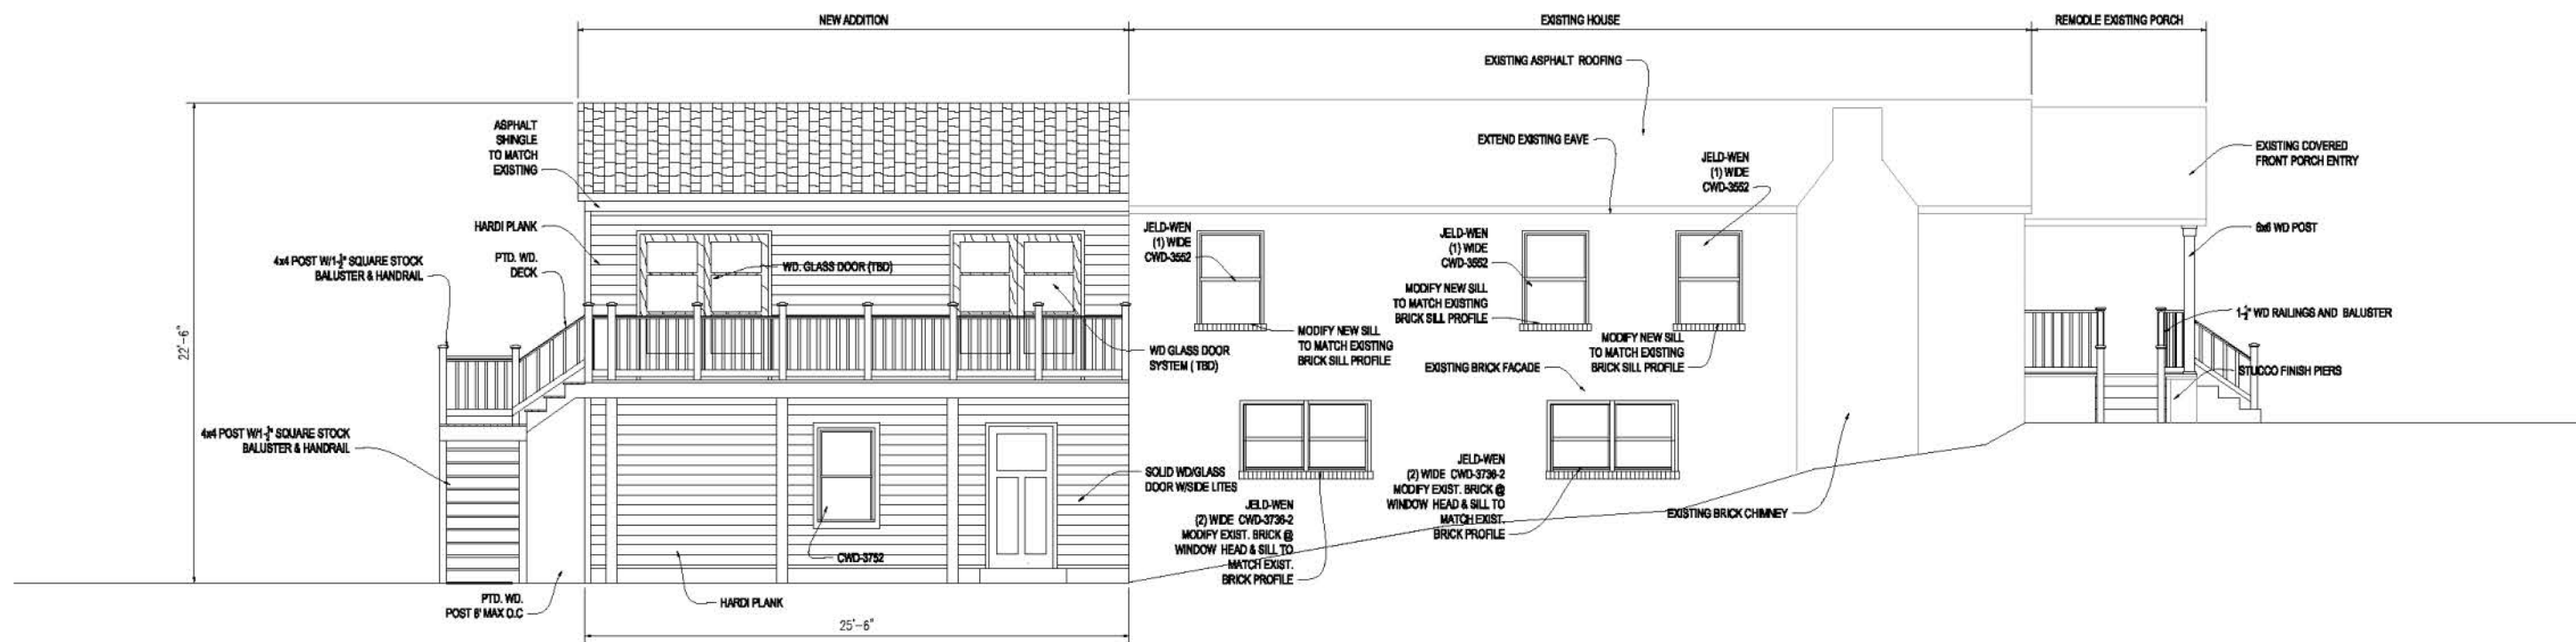


THOMAS & BEER RESIDENCE
 2302 NORTH KENMORE STREET
 MAYWOOD ARLINGTON, VA 22207

PROPOSED SOUTH ELEVATION
 SCALE: 1/8" = 1'-0"

JULY 2013

SHEET 3

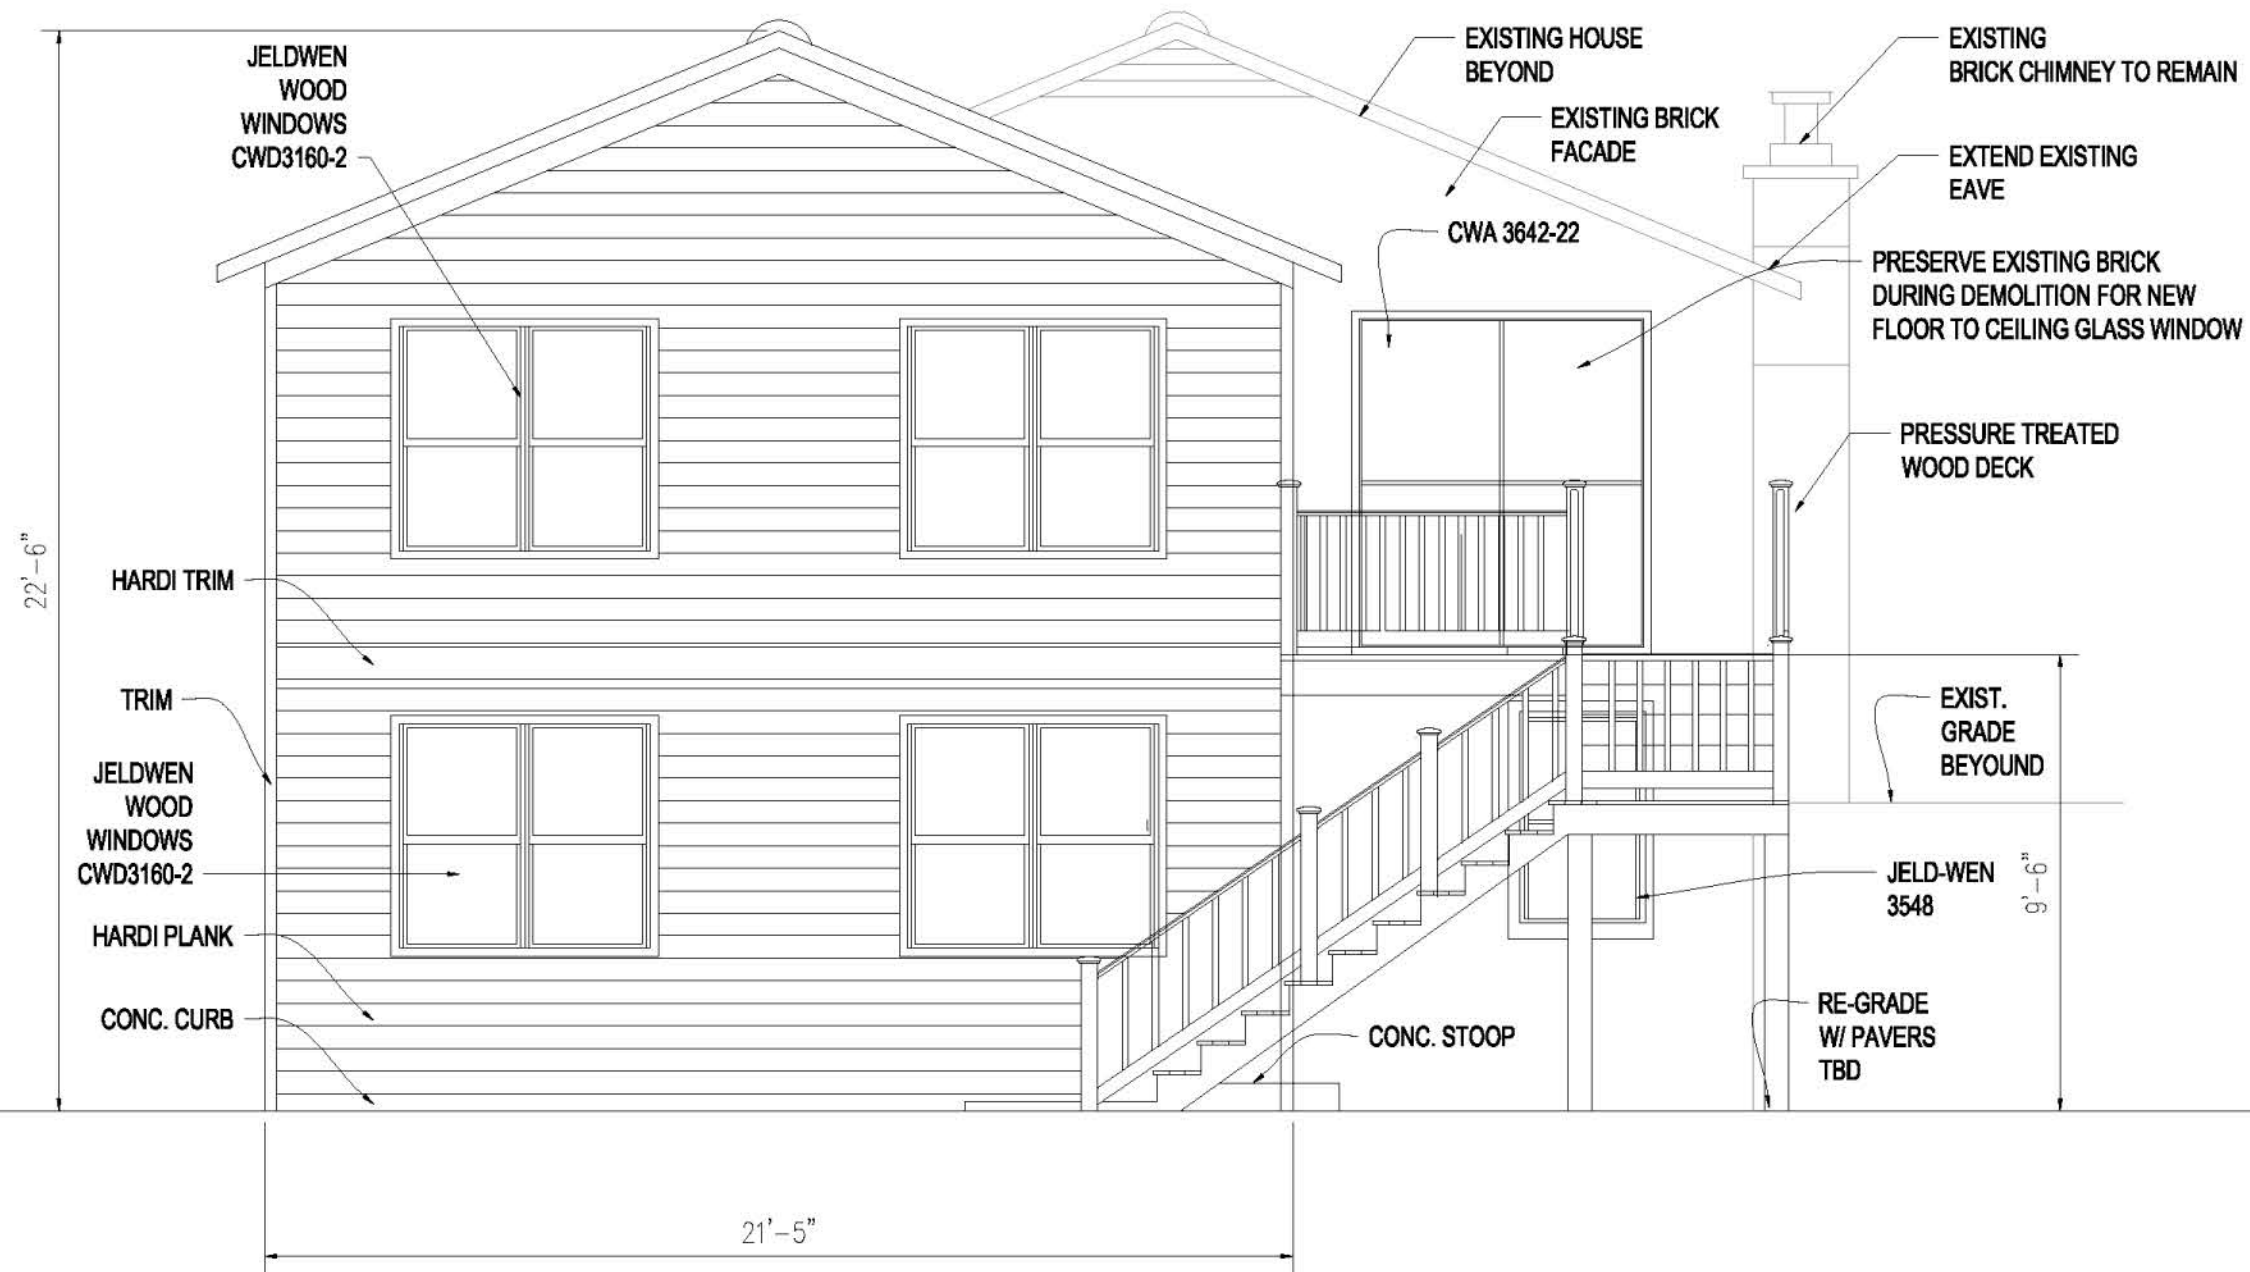

THOMAS & BEER RESIDENCE
 2302 NORTH KENMORE STREET
 MAYWOOD ARLINGTON, VA 22207

PROPOSED WEST ELEVATION
 SCALE: 1/4" = 1'-0"

JULY 2013

SHEET 4




THOMAS & BEER RESIDENCE
 2302 NORTH KENMORE STREET
 MAYWOOD ARLINGTON, VA 22207

PROPOSED NORTH ELEVATION
 SCALE: 1-8" = 1'-0"

JULY 2013

SHEET 5

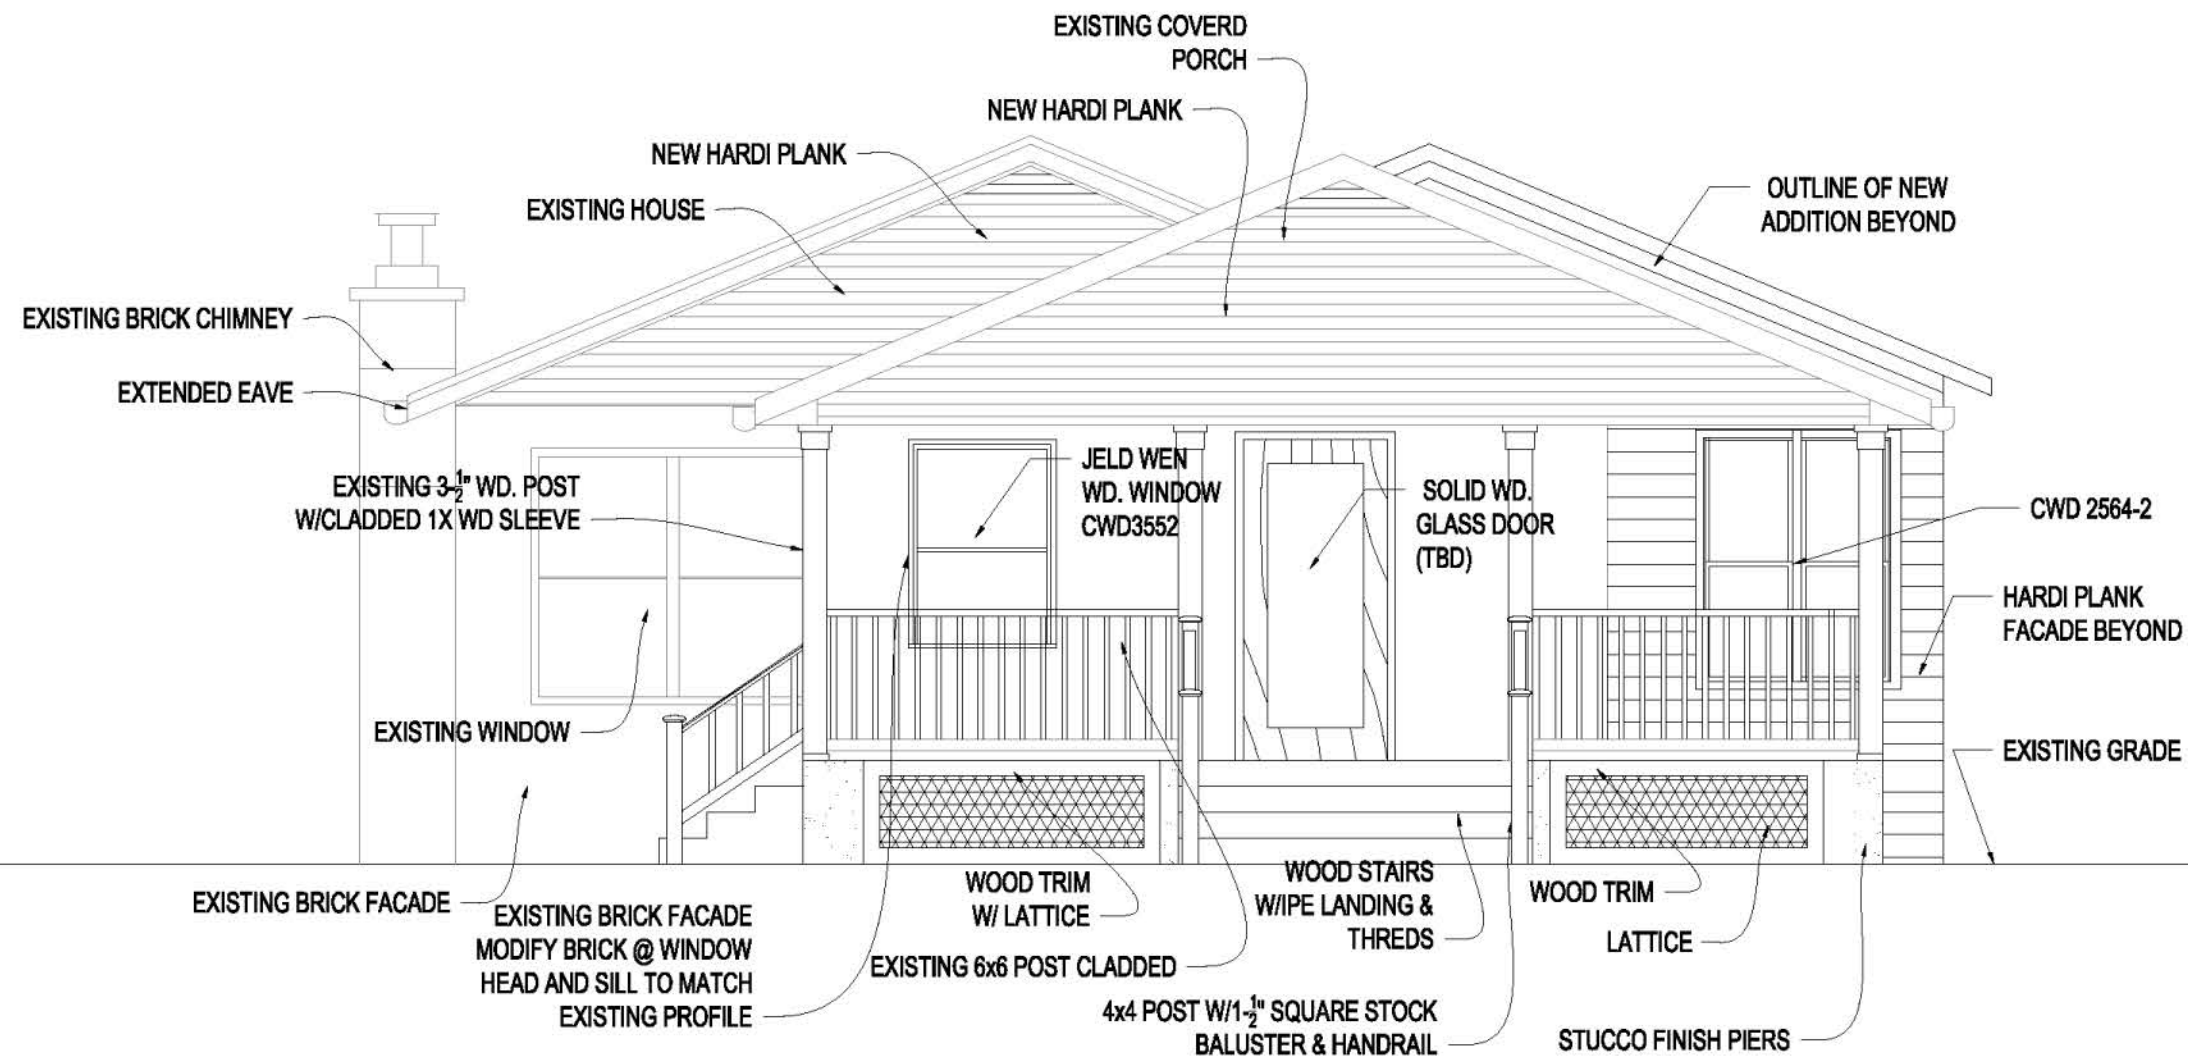

THOMAS & BEER RESIDENCE
 2302 NORTH KENMORE STREET
 MAYWOOD ARLINGTON, VA 22207

PROPOSED EAST ELEVATION
 SCALE: 1/4" = 1'-0"

JULY 2013

SHEET 6